

HEREFORDSHIRE COUNCIL

(A465 AYLESTONE HILL HEREFORD)(40 MPH SPEED LIMIT) ORDER 2012

The County of Herefordshire District Council ("known as Herefordshire Council"), in exercise of its powers under Section 84 of the Road Traffic Regulation Act 1984 and of all other enabling powers and after consultation with the Chief Officer of Police in accordance with Part III of Schedule 9 to the said Act hereby make the following Order:-

1. This Order may be cited as the Herefordshire Council (A465 Aylestone Hill, Hereford) (40 mph Speed Limit) Order 2012 and shall come into operation on the 14th day of March 2012.
2. No person shall drive a motor vehicle at a speed exceeding 40 miles per hour along the A465 as follows:

Between a point 491metres north of where the centre line of the A465 intersects the centre line of the U80300, (Overbury Road), and a point 60 metres south west of the junction of the A465 with the A4103 Roman Road.

and as shown for identification purposes only on the attached plan.

3. No speed limit imposed by this Order applies to vehicles falling within regulation 3(4) of the Road Traffic Exemption (Special Forces) (Variation Amendment) Regulations 2011 when used in accordance with regulation 3(5) of those regulations.
4. Without prejudice to the validity of anything done or to any liability incurred in respect of any act or omission before the coming into operation of this Order the following Order will be revoked in its entirety from the date mentioned in Article 1 of this Order:


The City Council of Hereford (40 mph Speed Limit) (Aylestone Hill) Order 1964.


5. Reference to any statutory provisions herein shall include reference to any statutory modification or re-enactment thereof.

Dated this 28 day of February 2012

THE COMMON SEAL of the **COUNTY OF
HEREFORDSHIRE DISTRICT COUNCIL**
was hereunto affixed **BY ORDER**

.....*Pete Gully*.....**Authorised Officer**

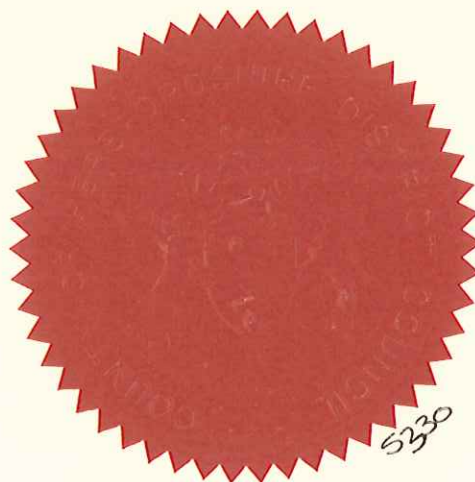

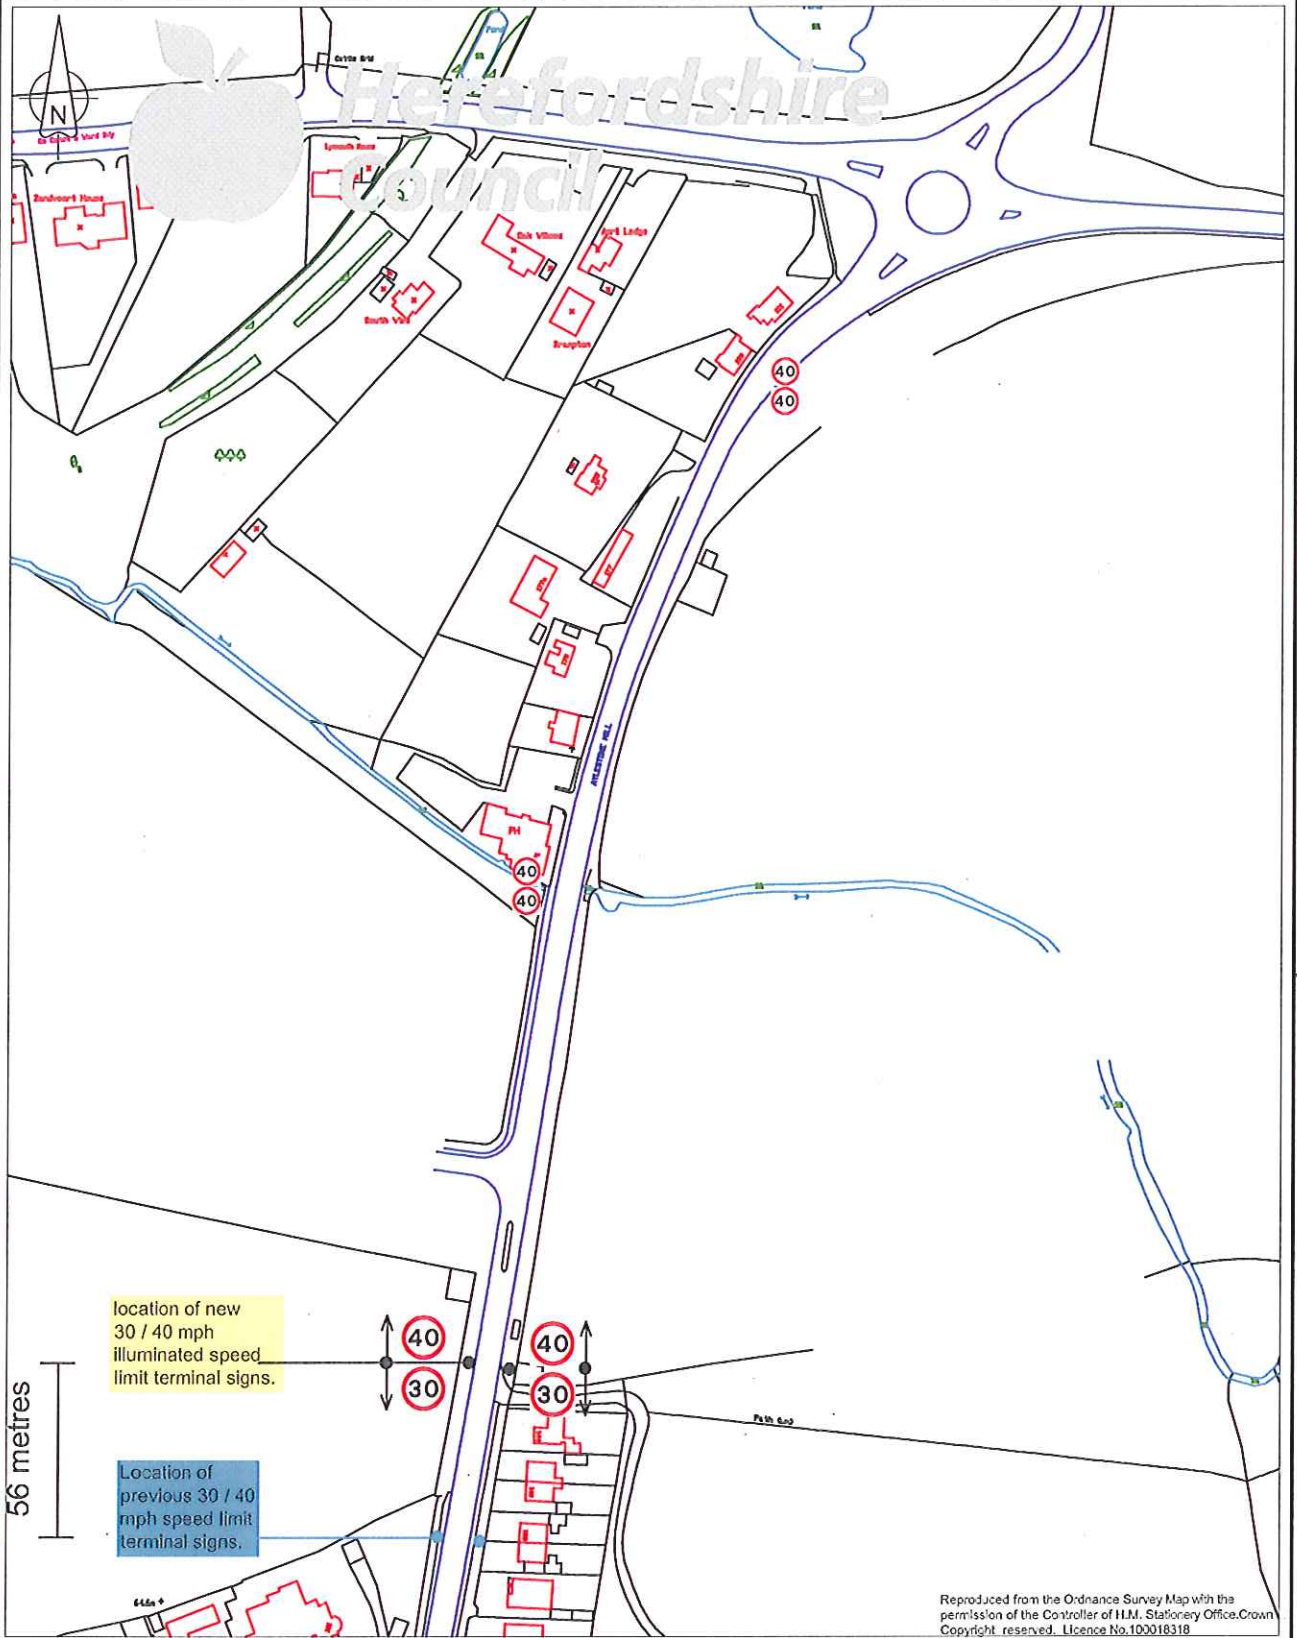


Reproduced from the Ordnance Survey Map with the permission of the Controller of H.M. Stationery Office. Crown Copyright reserved. Licence No.100018318

Rev	Revision details	Chkd	Appd	Date
Drawn: GKH	Preliminary			
Design: GKH	For comment			✓
Chkd: RW.	For tender			
Appd: .RW	For construction			
Date: .OCT 11	As constructed			
	Other			


Project Name
**A465 AYLESTONE HILL
 HEREFORD**

Drawing Title
**EXTENSION TO
 EXISTING 30 MPH
 SPEED LIMIT**

Original Drawing Size : A4
 Scale : N.T.S Dimensions : -



Client
G J HUGHES
 DIRECTOR OF SUSTAINABLE
 COMMUNITIES



Brockington, 35 Hatfield Road, Hereford, HR1 1SH Tel: (01432) 262750 Fax: (01432) 261263

Drawing No HD/T/HER/1567/1/C	Rev
--	-----

